

NOTES:

REVISIONS:

| | |
|---|--|
| 8 | |
| 7 | |
| 6 | |
| 5 | |
| 4 | |
| 3 | |
| 2 | |
| 1 | |


PROPOSED MECHANICAL AREA ENCLOSURE
SANDYPORT DRIVE
NEW PROVIDENCE, BAHAMAS

DRAWING ISSUE FOR:
REVISED PARKING LAYOUT

DRAWING TITLE:
SITE PLAN LAYOUT

DATE: MARCH 9, 2018
SCALE: AS SHOWN
DRAWN BY: S.A.M. SHEET NO.:
E1

THIS DRAWING IS AN INSTRUMENT OF SERVICE, AND THE PROPERTY OF ARTECH BAHAMAS LIMITED DESIGN AND OTHER INFORMATION SHOWN ON THIS DRAWING ARE FOR USE ON THE SPECIFIED PROJECT ONLY AND SHALL NOT BE OTHERWISE USED OR REPRODUCED WITHOUT THE WRITTEN PERMISSION FROM THE ARCHITECT.

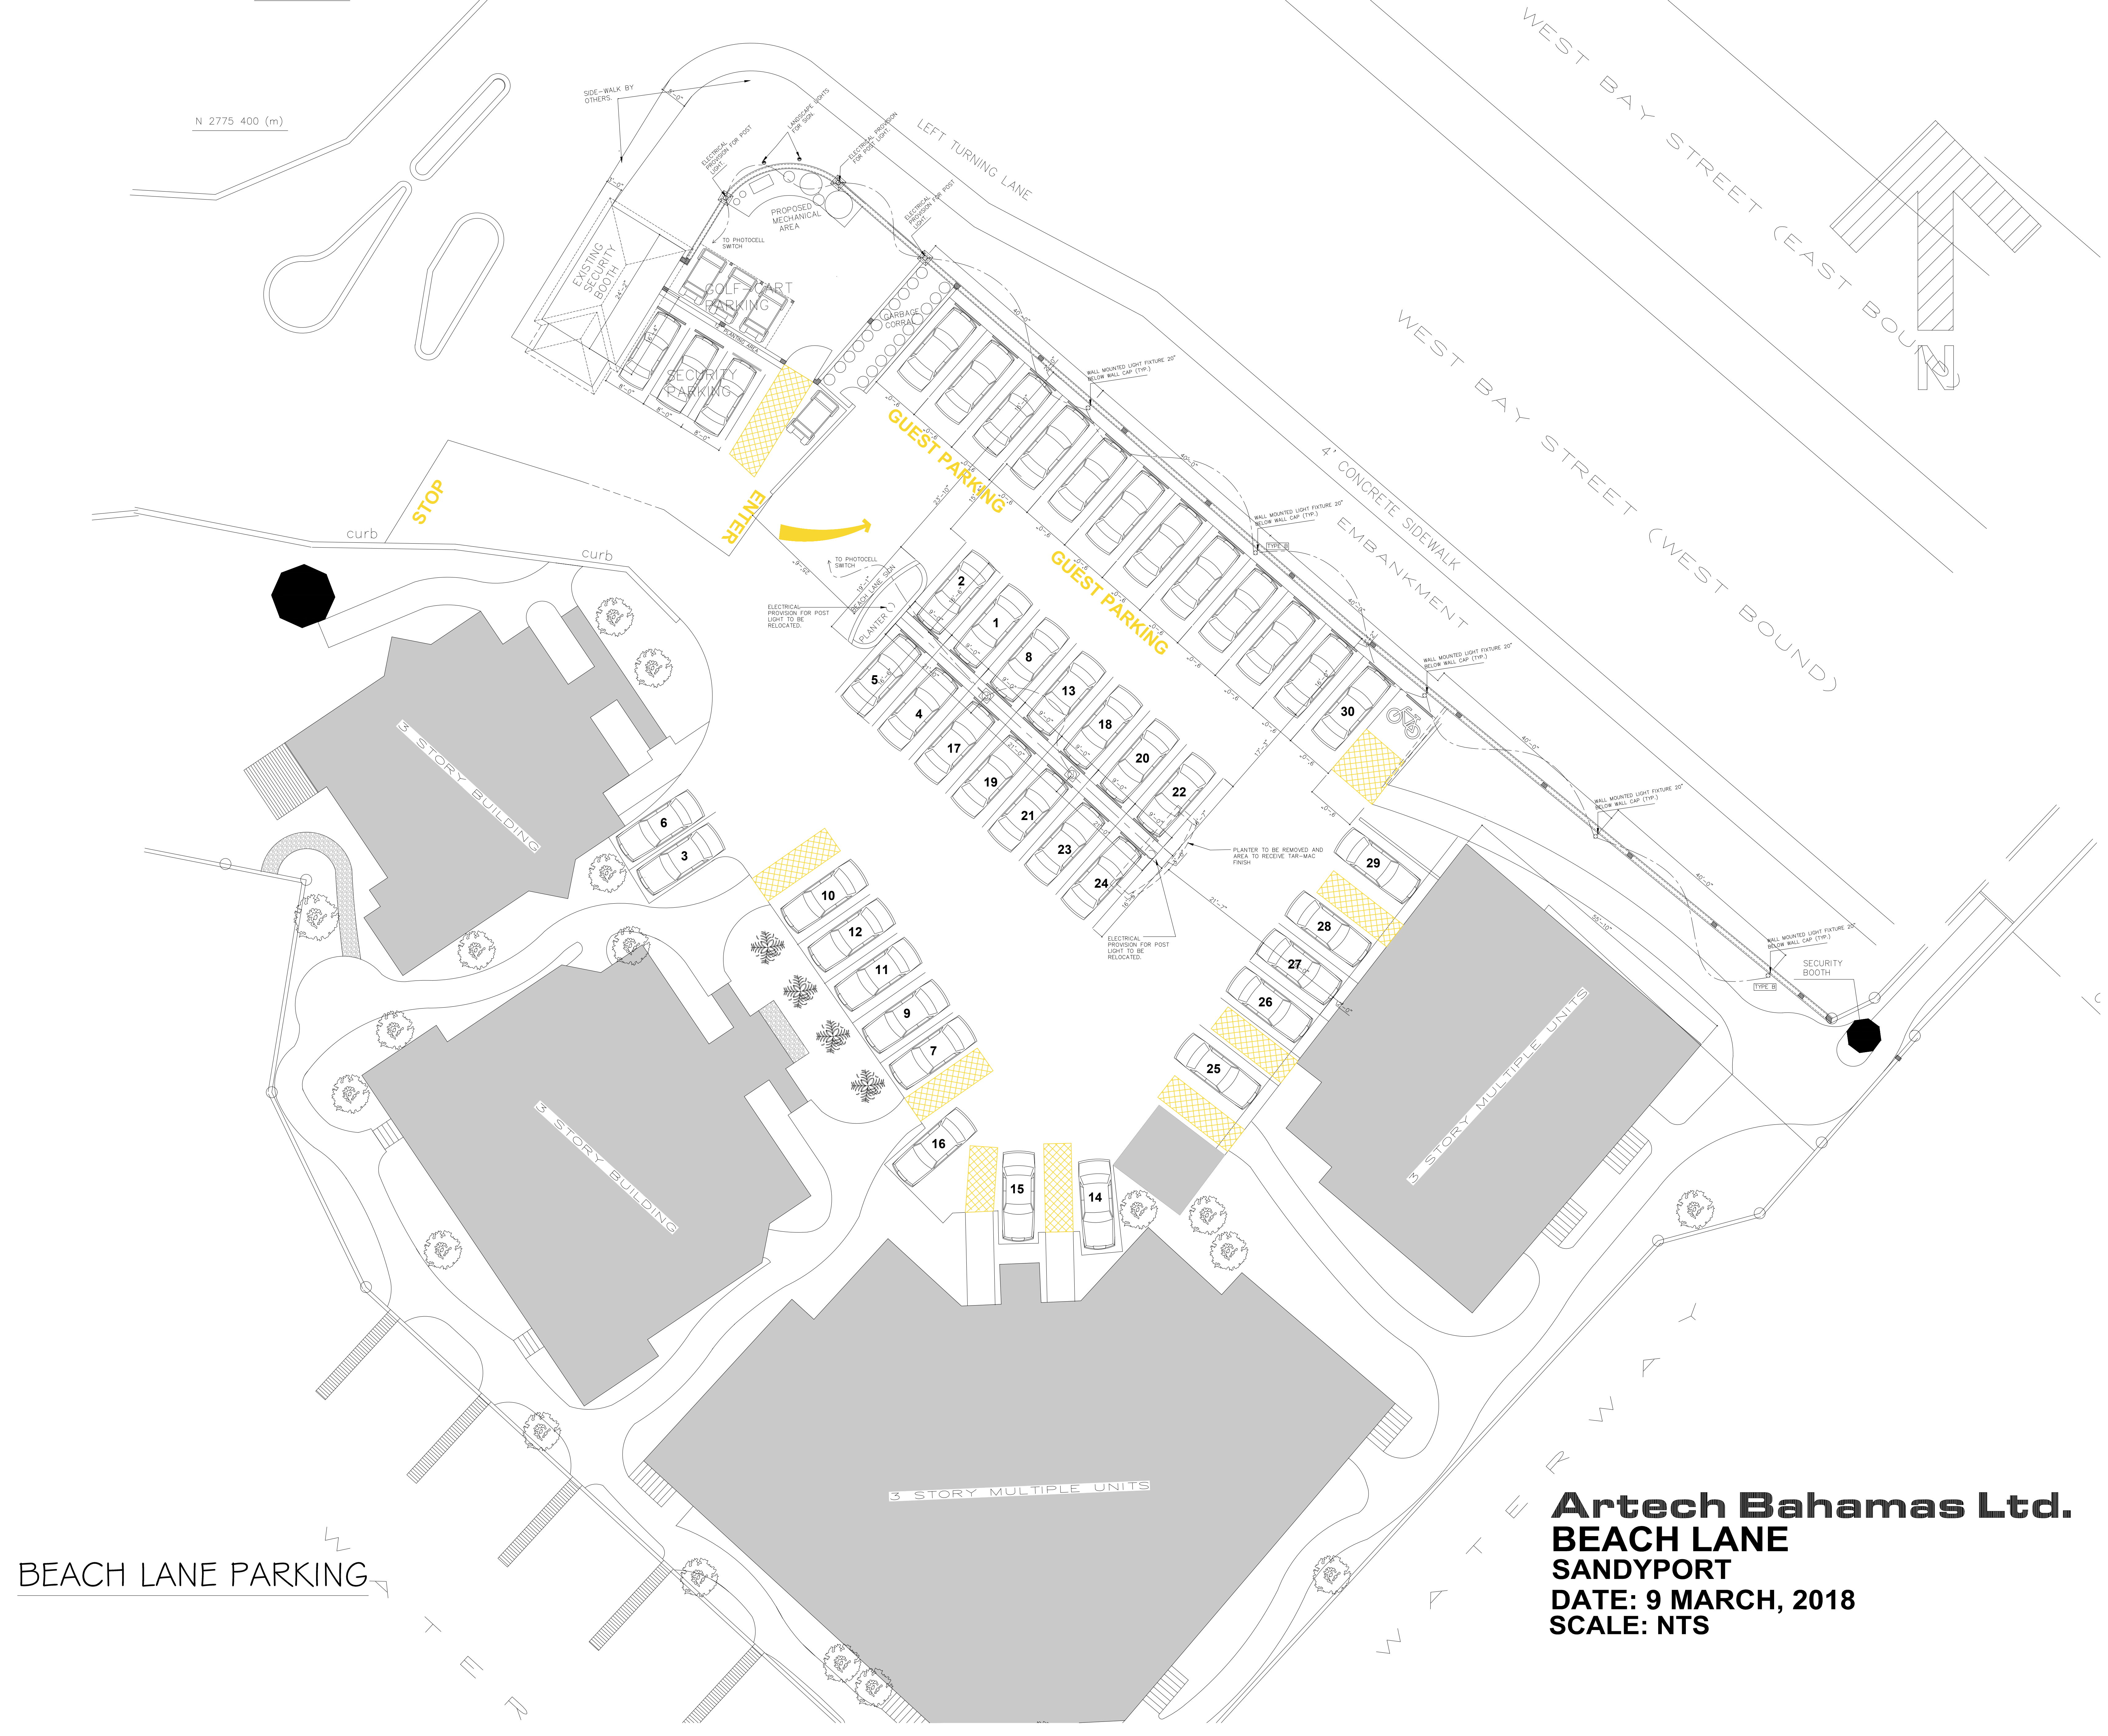

Artech Bahamas Ltd.
BEACH LANE
SANDYPORT
DATE: 9 MARCH, 2018
SCALE: NTS

BEACH LANE PARKING